


## AS BUILT - SIXTH FLOOR PLAN

Suite 600 27,683 RSF

Available Now

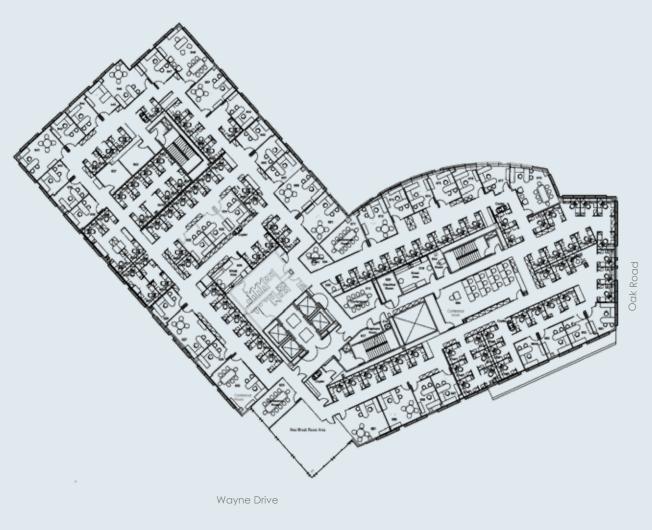

PERSONNEL	
Private office	±31
Workstations	55
Reception	1
Total headcount	87

## MEETING ROOMS LG conference 1 MD conference 2 SM conference 2

## Site Plan



## FOR LEASING INFORMATION

Robert Vance +1 925 944 2152 robert.vance@am.jll.com License # 00971934 Kevin Mechelke + 1 925 944 2142 kevin.mechelke@am.jll.com License #: 01338917

